DO NOT SCALE
IF IN DOUBT ASK

2650mm Suspended Ceiling To Rooms
2400mm Suspended Ceiling To Internal Corridors
No Suspended Ceiling To Link Corridor (FXD Ceiling)
Louvre Blinds To All Windows
Solar Film To All Windows

Window Details

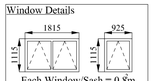

Each Window/Sash = 0.8m
White UPVC Frame
Double Glazed
K Glass
Trickle Vents - Equal To 4000mm
Restrictor Stays
Lockable Handles

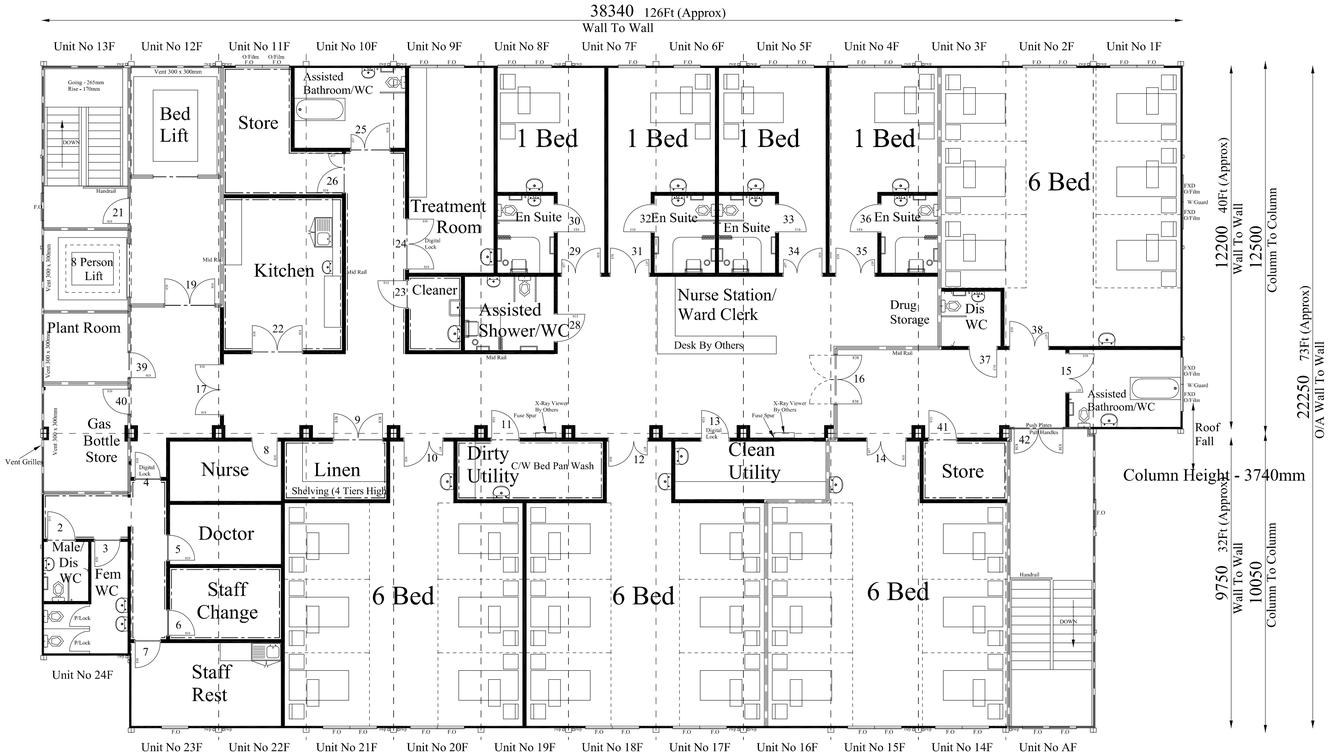

First Floor

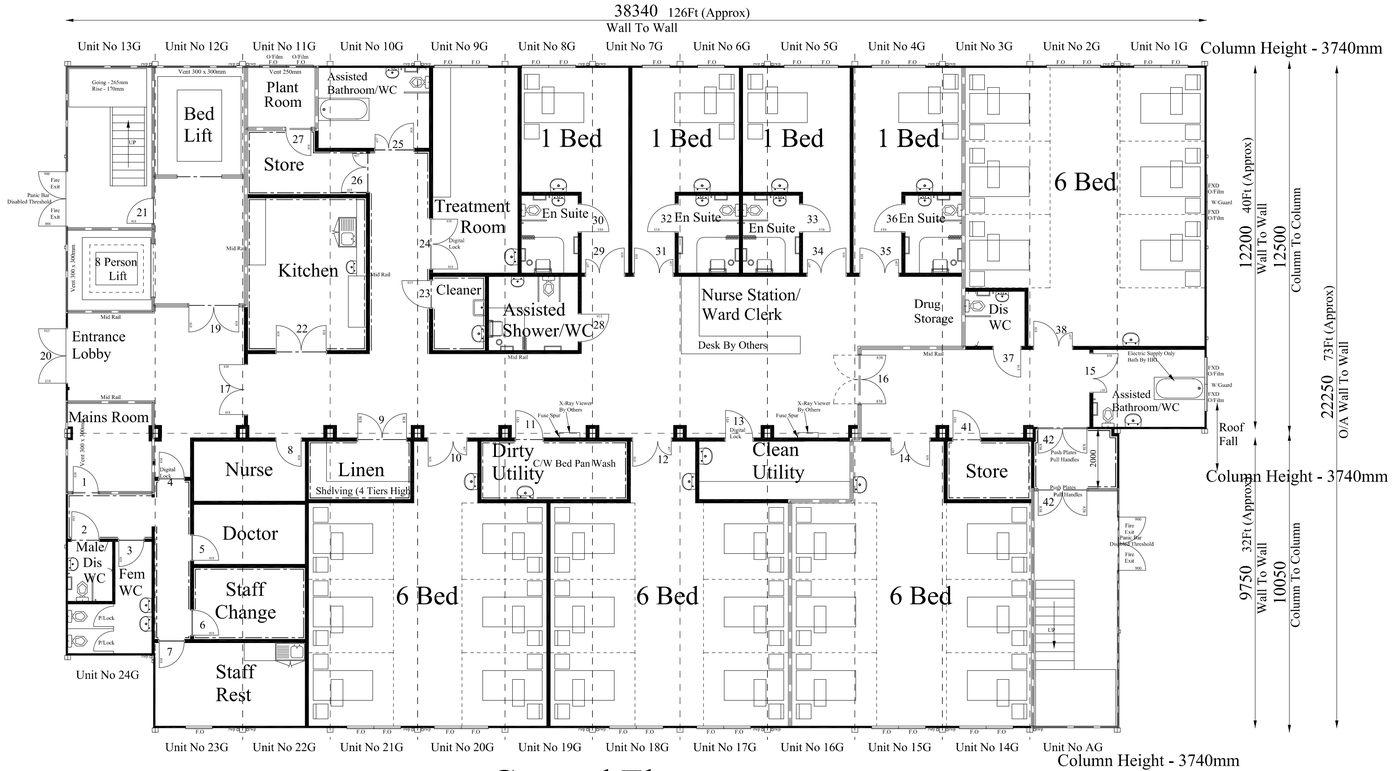

Ground Floor

NOTES:
All dimensions must be checked on site and not scaled from this drawing.

SQM AREA = 1707 SQM
SQFT AREA = 18363 SQFT

Fire Walls

1 Hour Fire Wall

1/2 Hour Fire Wall

Rev	Date	Revisions

© copyright

Foremans
Relocatable Building Systems
Catfoss Lane, Brandesburton,
Driffield, East Yorkshire, YO25 8EJ
Telephone : 01964 544344 Fax : 01964 542141
E-mail : sales@foremansbuildings.co.uk
Web : http//www.foremansbuildings.co.uk

Client.

Job Title.

25 On 25 Bays Of Portakabin Duplex Modular Building

Drawing Title

As Built Drawing

Scale 1 =100

Date 28/07/2003

Drawn by R.A.HOOK

Drg No. Health 001-1

Rev.